

December 12, 2013

Ms. Enza Morero
City of San Diego | Real Estate Assets Department
Property Agent | Telecommunications Division
1200 Third Avenue, Suite 1700, San Diego, CA 92101

RE: Telecom Master Lease Agreement between The City of San Diego and Nextel of California, Inc. and Sprint PCS Assets LLC (Sprint Nextel or Tenant), dated January 8, 2007 (Site Agreement), with respect to the real property located at 10907 Scripps Poway Parkway/Spring Canyon Park, San Diego, CA 92131, City ID No. 1620RD/002/A00, Cascade No. SD03XC022

Dear Ms. Morero:

This letter is to advise you that it will be necessary within the near future for Sprint Nextel to make certain physical modifications to equipment within Tenant's premises at the Site. These improvements are being undertaken in order to ensure the continued technical and economic feasibility of Tenant's facility, and are needed for Tenant to make optimal use of the Site for the purposes intended by the Site Agreement. As described below, these modifications should have no significant impact on Landlord's property or operations. However, in accordance with the Site Agreement, Tenant requests that Landlord acknowledge notice of, and consent to, the following modifications:

Swap out of obsolete electronics cabinets, antenna and other equipment at the site. This may include replacement of cabling and mounting apparatus and the temporary redundancy of equipment within the leased area necessary for testing of the new equipment for up to 12 months.

Landlord's acknowledgement of notice and consent will not increase the size or amount of space being used by Tenant under the Site Agreement unless specifically stated above.

Please indicate your acknowledgement and consent by signing below and returning one copy of this letter to me at the address set forth above.

Thank you in advance for your prompt attention to this matter.

Regards,

ACKNOWLEDGED AND AGREED TO:
City of San Diego | Real Estate Assets Department

Alexander K. Novak

By: Alexander K. Novak, Novation Group
an authorized representative of Sprint Nextel

Printed Name: **James F. Barwick, CCIM**
Title: **Director, Real Estate Assets**
Date: 12/16/13, 2013

PH:847-430-3547

FAX:847-430-3549

**Novation Group Consulting, Ltd.
132 S Delphia Ave
Park Ridge, IL 60068**



THE CITY OF SAN DIEGO

Date of Notice: December 2, 2013

NOTICE OF DECISION

DEVELOPMENT SERVICES DEPARTMENT

Internal Order No. 24003841

APPROVAL TYPE(S): NEIGHBORHOOD USE PERMIT and
NEIGHBORHOOD DEVELOPMENT PERMIT
PROJECT NAME/NUMBER: SPRINT – SCRIPPS POWAY PARKWAY/327630
APPLICANT: ALEXANDER NOVAK, NOVATION GROUP
CONSULTING, LTD, AGENTS REPRESENTING
SPRINT

COMMUNITY PLAN AREA: MIRAMAR RANCH NORTH
COUNCIL DISTRICT: 5

CITY PROJECT MANAGER: ALEX HEMPTON, Development Project Manager
MAILING ADDRESS: 1222 First Avenue, MS 501, San Diego, CA 92101-4153
PHONE NUMBER/E-MAIL: (619) 446-5349 / ahempton@sandiego.gov

On December 2, 2013, Development Services Staff APPROVED an application for a Wireless Communication Facility (WCF) consisting of 3 panel antennas mounted on an existing stadium light standard with equipment associated with the antennas located in an above-ground equipment shelter in the park. The project is located at 10907 Scripps Poway Parkway.

If you have any questions about this project, the decision, or wish to receive a copy of the resolution approving or denying the project, contact the City Project Manager above.

The decision by staff can be appealed to the **Planning Commission** no later than twelve (12) business days (December 18, 2013) of the decision date. See Information Bulletin 505 "Appeal Procedure", available at www.sandiego.gov/development-services or in person at the Development Services Department, located at 1222 First Avenue, 3rd Floor, San Diego, CA 92101. Please do not e-mail your appeal as it will not be accepted. The decision of the Planning Commission is final.

This project was determined to be categorically exempt from the California Environmental Quality Act on November 8, 2013 and the opportunity to appeal that determination ended November 29, 2013.

This information will be made available in alternative formats for persons with disabilities upon request.

cc: LORAYNE BURLEY, CHAIR, MIRAMAR RANCH NORTH PLANNING COMMITTEE



THE CITY OF SAN DIEGO

July 3, 2013

Alexander Novak
Novation Group, agents representing Sprint

Sent via e-mail only to: alex@novationgroup.com

Dear Alexander Novak:

Subject: Sprint – Scripps Poway Pkwy, Completeness Review
Project No. 327630; Internal Order No. 24003841
Located at: 10907 Scripps Poway Parkway

The Development Services Department [DSD] has conducted a Completeness Review of the above-referenced telecom project.

Enclosed you will find a Cycle Issues Report, which contains comments from staff representing various disciplines and outside agencies. Please resubmit your project application with the information and the revisions requested in the enclosed Cycle Issues Report as soon as possible to facilitate the most efficient processing of your project. Once the project application is resubmitted with the requested information and revisions, and any required additional deposit is paid, your project will be "Deemed Complete" for purposes of compliance with the Permit Streamlining Act (California Government Code sections 65920-65964) and for purposes of compliance with the FCC "Shot Clock" Ruling (FCC 09-99, Nov. 18, 2009). Please review Information Bulletin 536 for updated submittal information:

<http://www.sandiego.gov/development-services/industry/pdf/infobulletin/ib536.pdf> Ensuring that your project addresses each of the submittal requirements will facilitate the processing of your project.

Your project is located on a City of San Diego property managed by the Park & Recreation Department. We encourage you to present your project to the Recreation Council this park for a recommendation, in addition to the local community planning group. If you have problems contacting the Recreation Council, or for other issues related to the Park & Recreation Department, please contact Jeff Harkness, Park Designer and Development Services' Liaison, at JHarkness@sandiego.gov or 619-533-6595.

If additional requirements arise during the subsequent review of your project, DSD will identify the issues and the reasons for the additional requirements. If you resubmit your project but fail to provide the information or make the revisions requested in the enclosed or subsequent Cycle Issues Reports, DSD will continue to process the project; however, the project may be

DEVELOPMENT SERVICES DEPARTMENT
ENTITLEMENTS – TELECOM PROJECT MANAGEMENT
1222 FIRST AVENUE, MS 501 • SAN DIEGO, CA 92101
PHONE: 619-446-5000 • FAX: 619-446-5499

recommended for denial, if the remaining issues cannot be satisfactorily resolved or the appropriate findings for approval cannot be made.

To avoid the closure of your application file, you must resubmit your project with the information and revisions requested in the enclosed Cycle Issues Report **on or before August 5, 2013**. When you are ready to resubmit your project, please call (619) 446-5300 to make an appointment for a "Discretionary Submittal." Submittals may also be done on a walk-in basis, however, you may experience a longer than desirable wait time. In either case, please check in on the third floor of the Development Service Center at 1222 First Avenue, San Diego, CA 92101. Please note that during the time it takes for you to resubmit your project application, your application will be tolled for purposes of the time periods specified in the FCC Shot Clock Ruling and the Permit Streamlining Act.

At your appointment, please provide the plans, information, revisions, and/or other documentation requested in the enclosed Cycle Issues Report. The plans should be folded to an approximate 8 ½ x 11 inch size.

Please contact me if you have any questions regarding this letter, the information and revisions requested in the enclosed Cycle Issues Report, and/or any modifications to the project scope. I may be reached by phone at (619) 446-5349 or via e-mail at ahempton@sandiego.gov.

Sincerely,

Alex Hempton, AICP
Development Project Manager

Enclosures:

1. Cycle Issues Report
2. Submittal Requirements

cc: File

Cycle Issues



THE CITY OF SAN DIEGO
Development Services

1222 First Avenue, San Diego, CA 92101-4154

7/3/13 4:47 pm

Page 1 of 2

L64A-003A

Project Information

Project Nbr: **327630** Title: Sprint Scripps Poway Pkwy
Project Mgr: Hempton, Alexander (619) 446-5349

Ahempton@sandiego.gov



Review Information

Cycle Type: 1 Completeness Review-Telecom	Submitted: 06/18/2013	Deemed Complete on 06/20/2013
Reviewing Discipline: ITC-Communications	Cycle Distributed: 06/20/2013	
Reviewer: Hempton, Alexander (619) 446-5349 Ahempton@sandiego.gov	Assigned: 06/25/2013	
	Started: 06/25/2013	
Hours of Review: 0.25	Review Due: 07/05/2013	
Next Review Method: Submitted (Multi-Discipline)	Completed: 07/03/2013	COMPLETED ON TIME
	Closed: 07/03/2013	

- . The reviewer has indicated they want to review this project again. Reason chosen by the reviewer: First Review Issues.
- . We request a 2nd complete submittal for ITC-Communications on this project as: Submitted (Multi-Discipline).
- . The reviewer has requested more documents be submitted.
- . Your project still has 1 outstanding review issues with ITC-Communications (all of which are new).
- . Last month ITC-Communications performed 19 reviews, 21.1% were on-time, and 84.2% were on projects at less than < 3 complete submittals.

Completeness Review

<u>Issue</u>		
<u>Cleared?</u>	<u>Num</u>	<u>Issue Text</u>
☐	1	This installation uses antennas located on City park lighting. The lighting may be maintained by city workers. The carrier should be made aware that appropriate signs should be installed to notify employees working on the light standard that a hazard exists and the location of the hazard. The carrier should be required to assess the level and location of the hazard and place the appropriate signs per CAL-OSHA requirements. (New Issue)





Cycle Issues

7/3/13 4:47 pm

Page 2 of 2

THE CITY OF SAN DIEGO
Development Services

1222 First Avenue, San Diego, CA 92101-4154

L64A-003A

Review Information

Cycle Type: 1 Completeness Review-Telecom	Submitted: 06/18/2013	Deemed Complete on 06/20/2013
Reviewing Discipline: LDR-Planning Review	Cycle Distributed: 06/20/2013	
Reviewer: Hempton, Alexander	Assigned: 06/25/2013	
(619) 446-5349	Started: 06/25/2013	
Ahempton@sandiego.gov	Review Due: 07/05/2013	
Hours of Review: 1.00	Completed: 07/03/2013	COMPLETED ON TIME
Next Review Method: Submitted (Multi-Discipline)	Closed: 07/03/2013	

- The reviewer has indicated they want to review this project again. Reason chosen by the reviewer: First Review Issues.
- We request a 2nd complete submittal for LDR-Planning Review on this project as: Submitted (Multi-Discipline).
- The reviewer has requested more documents be submitted.
- Your project still has 6 outstanding review issues with LDR-Planning Review (all of which are new).
- Last month LDR-Planning Review performed 99 reviews, 36.4% were on-time, and 54.8% were on projects at less than < 3 complete submittals.

Completeness Review

Cleared?	Issue	
	Num	Issue Text
☐	1	This WCF is proposed in a park in a residential zone. The antennas are located more than 100 ft. from the property line of a residential use, day care, elementary school, or middle school.
		This project can be processed with a Neighborhood Use Permit, Process 2, and a Neighborhood Development Permit for the above-ground equipment shelter located in the park. (New Issue)
☐	2	Incorrect address on plans. Revise site address to 10907 Scripps Poway Parkway. (New Issue)
☐	3	Indicate zone - RS-1-4 on plans. (New Issue)
☐	4	On A-2, dimension the diameter of the antenna radome. (New Issue)
☐	5	On elevations, indicate that the radome cover will be painted to match pole. (New Issue)
☐	6	Dimension size (height) of antenna radome on elevations. (New Issue)





Submittal Requirements

7/3/13 4:52 pm

THE CITY OF SAN DIEGO
Development Services

Page 1 of 1

L64A-001

1222 First Avenue, San Diego, CA 92101-4154

Project Information

Project Nbr: **327630** Title: Sprint Scripps Poway Pkwy

Project Mgr: Hempton, Alexander

(619)446-5349

Ahempton@sandiego.gov



Review Cycle Information

Review Cycle: 2 Submitted (Multi-Discipline)

Opened: 07/03/2013 4:46 pm

Submitted:

Due:

Closed:

Required Documents:

Package Type

Pkg Qty Document Type

Qty Needed

Noticing	1	Supplemental Discretionary Application (DS-3035)	1
Telcom Technical Analysis	1	Telecom Justification Map	1
Project File	1	General Application (DS-3032)	1
Applicant Correspondence	6	Applicant Correspondence	6
Dev. Plans reduced 11x17	6	Dev. Plans reduced 11x17	6
Telcom Technical Analysis	1	Telecom Coverage Map	1
Telcom Technical Analysis	1	Telecom Site Justification Letter	1
Photo Simulations	6	Photo Simulations	6
Noticing	1	Public Notice Package	1





November 14, 2013

City of San Diego (Landlord)
1200 Third Avenue, Suite 1700
San Diego CA 92101

RE: Property located at 2101 Pershing Dr. Cascade No. SD03XC009

Dear Sir or Madam:

This letter is to advise you that it will be necessary within the near future for Sprint Nextel to make certain physical modifications to equipment within Tenant's premises at the Site. These improvements are being undertaken in order to ensure the continued technical and economic feasibility of Tenant's facility, and are needed for Tenant to make optimal use of the Site for the purposes intended by the Site Agreement. As described below, these modifications should have no significant impact on Landlord's property or operations. However, in accordance with the Site Agreement, Tenant requests that Landlord acknowledge notice of, and consent to, the following modifications:

Swap out of obsolete electronics cabinets, antenna and other equipment at the site. This may include replacement of cabling and mounting apparatus and the temporary redundancy of equipment within the leased area necessary for testing of the new equipment for up to 12 months.

Landlord's acknowledgement of notice and consent will not increase the size or amount of space being used by Tenant under the Site Agreement unless specifically stated above.

Please indicate your acknowledgement and consent by signing below and returning one copy of this letter to me at the address set forth above.

Thank you in advance for your prompt attention to this matter.

Regards,


Technology Associates

By: _____


Joanne Aguzar, an authorized representative of Sprint Nextel

ACKNOWLEDGED AND AGREED TO:

City of San Diego

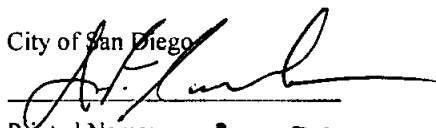


Printed Name: James F. Barwick, CCIM

Title: Director, Real Estate Assets

Date: _____, 201____
(Date must be completed)

5333 Mission Center Rd., Ste. 220
San Diego, CA 92108
Mobile Phone: (858) 442-7235
Email: joanne.aguzar@taec.net
www.taec.net

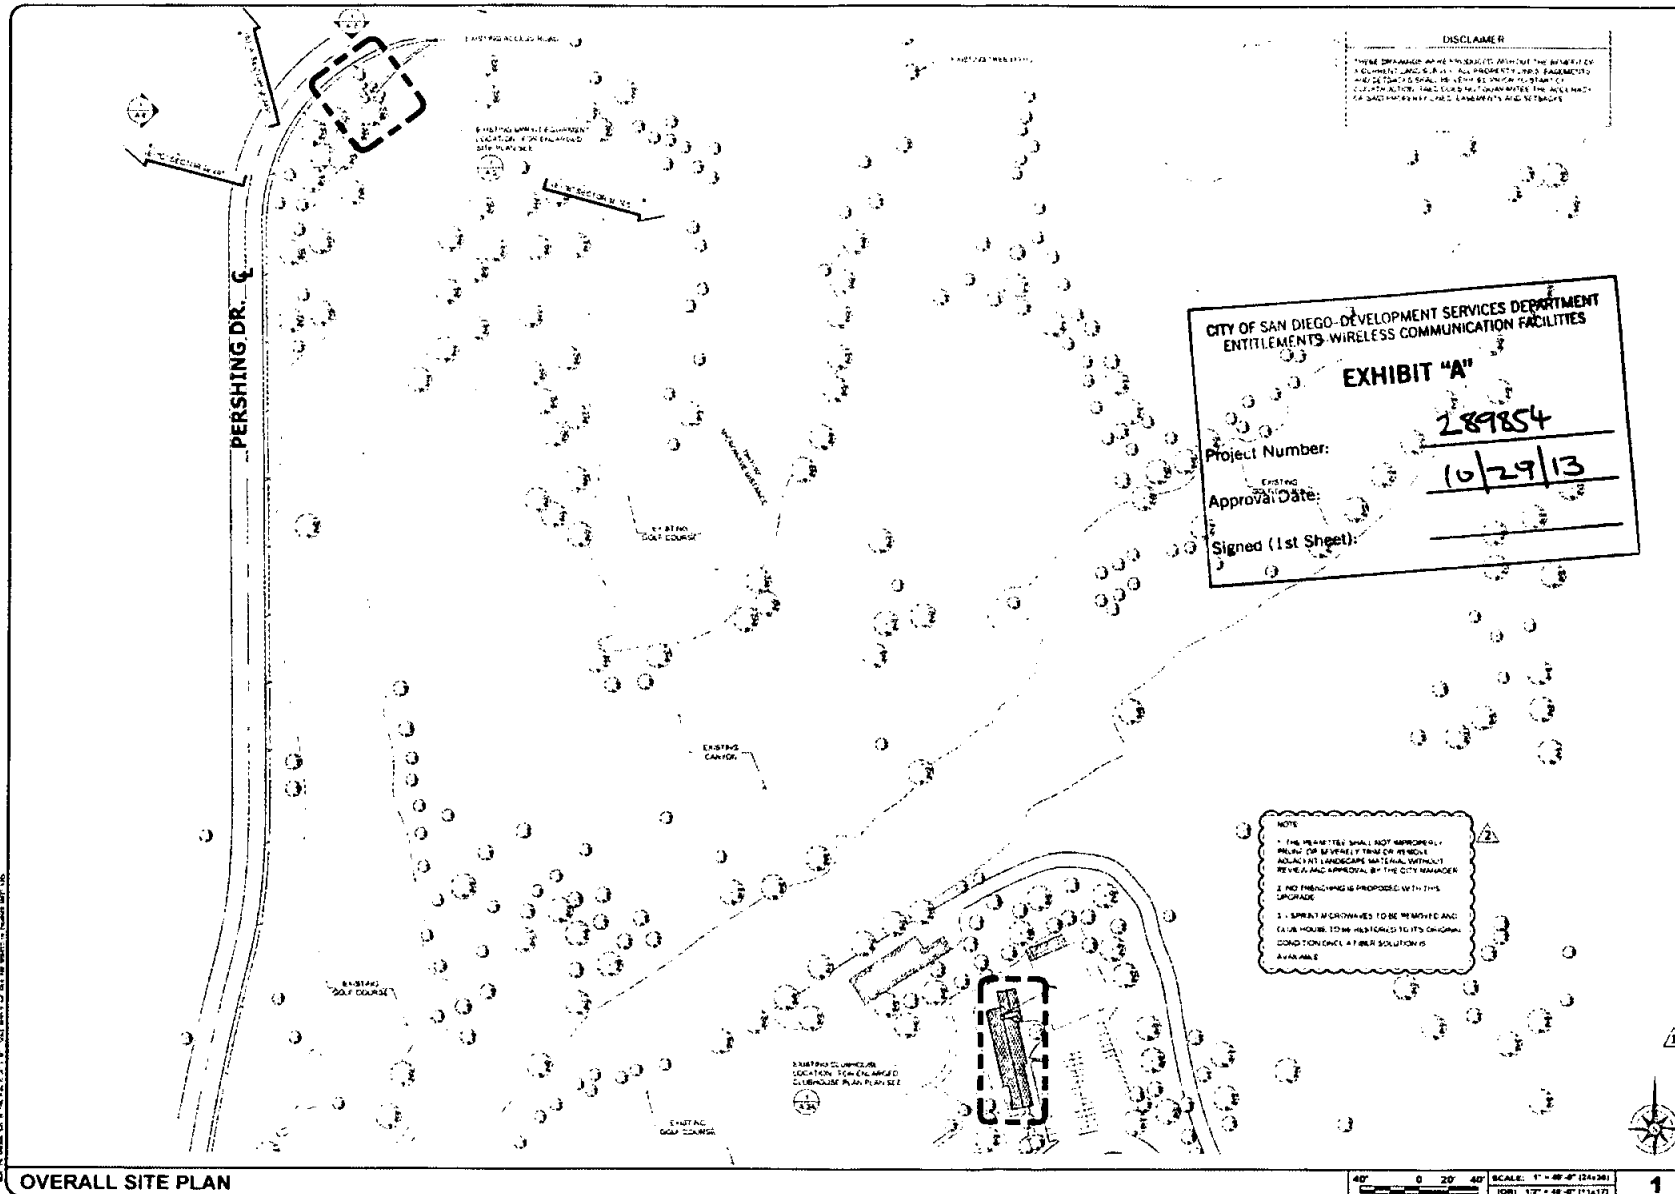

Sprint

Alcatel-Lucent

PLANS PREPARED BY:

Technology Associates Engineering Corporation Inc.
 SAN DIEGO MARKET OFFICE
 5473 KEARNY VILLA RD., STE. 300
 SAN DIEGO, CA 92123

PROPRIETARY INFORMATION
 THE INFORMATION CONTAINED HEREIN IS THE PROPERTY OF TECHNOLOGY ASSOCIATES ENGINEERING CORPORATION. IT IS NOT TO BE REPRODUCED OR TRANSMITTED IN ANY FORM OR BY ANY MEANS, ELECTRONIC OR MECHANICAL, INCLUDING PHOTOCOPYING, RECORDING, OR BY ANY INFORMATION STORAGE AND RETRIEVAL SYSTEM, WITHOUT THE WRITTEN PERMISSION OF TECHNOLOGY ASSOCIATES ENGINEERING CORPORATION.

PROJECT INFORMATION:
 NETWORK VISION UMBTS LAUNCH
E. FLORID
SD03XC009
 2101 PERSHING DRIVE
 SAN DIEGO, CA 92102

ISSUE DATE:
07/22/2013
ISSUED FOR:
100% ZD SUBMITTAL


REVISIONS			
REV.	DATE	DESCRIPTION	BY
0	07/24/13	ISSUED FOR 100% ZD REVIEW	AC
1	07/24/13	ISSUED FOR 100% ZD REVIEW	AC
LICENSURE:

SHEET TITLE:
OVERALL SITE PLAN

SHEET NUMBER:
A-1

REVISION:
2

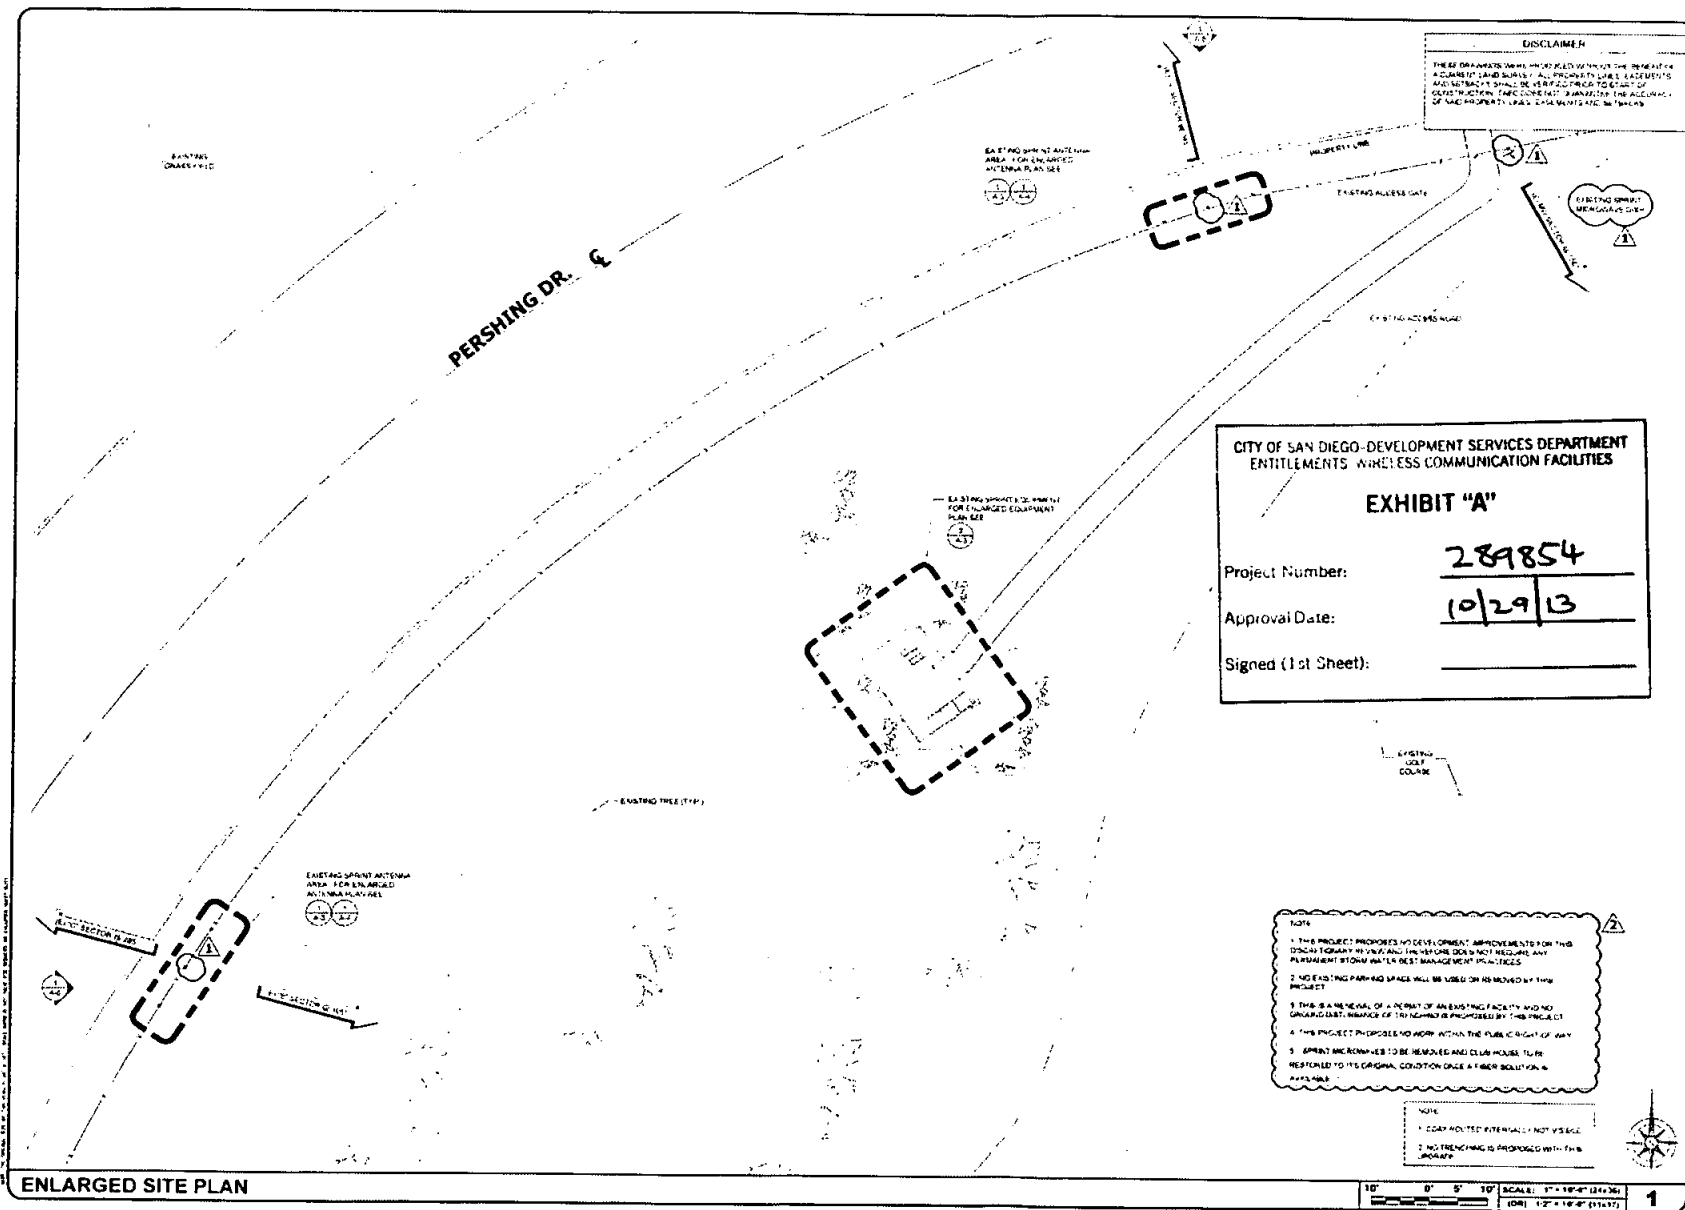

Sprint

Alcatel-Lucent

PLANS PREPARED BY:
Technology Associates Engineering Corporation Inc.
 SAN DIEGO MARKET OFFICE
 5473 KEARNY VILLA RD. STE. 350
 SAN DIEGO, CA 92123

PROPRIETARY INFORMATION

PROJECT INFORMATION:

NETWORK VISION MMBS LAUNCH

E. FLORID

SD03XC009

2101 PERSHING DRIVE
 SAN DIEGO, CA 92102

ISSUE DATE:

07/22/2013

ISSUED FOR:

100% ZD SUBMITTAL

REVISIONS

REV.	DATE	DESCRIPTION	BY
0	07/22/13	ISSUED FOR 100% ZD REVIEW	AC
1	08/14/13	ISSUED FOR 100% ZD REVIEW	AC
2	08/14/13	ISSUED FOR 100% ZD SUBMITTAL	AC

LICENSURE:


SHEET TITLE:

ENLARGED SITE PLAN

SHEET NUMBER:

REVISION:

A-2 2

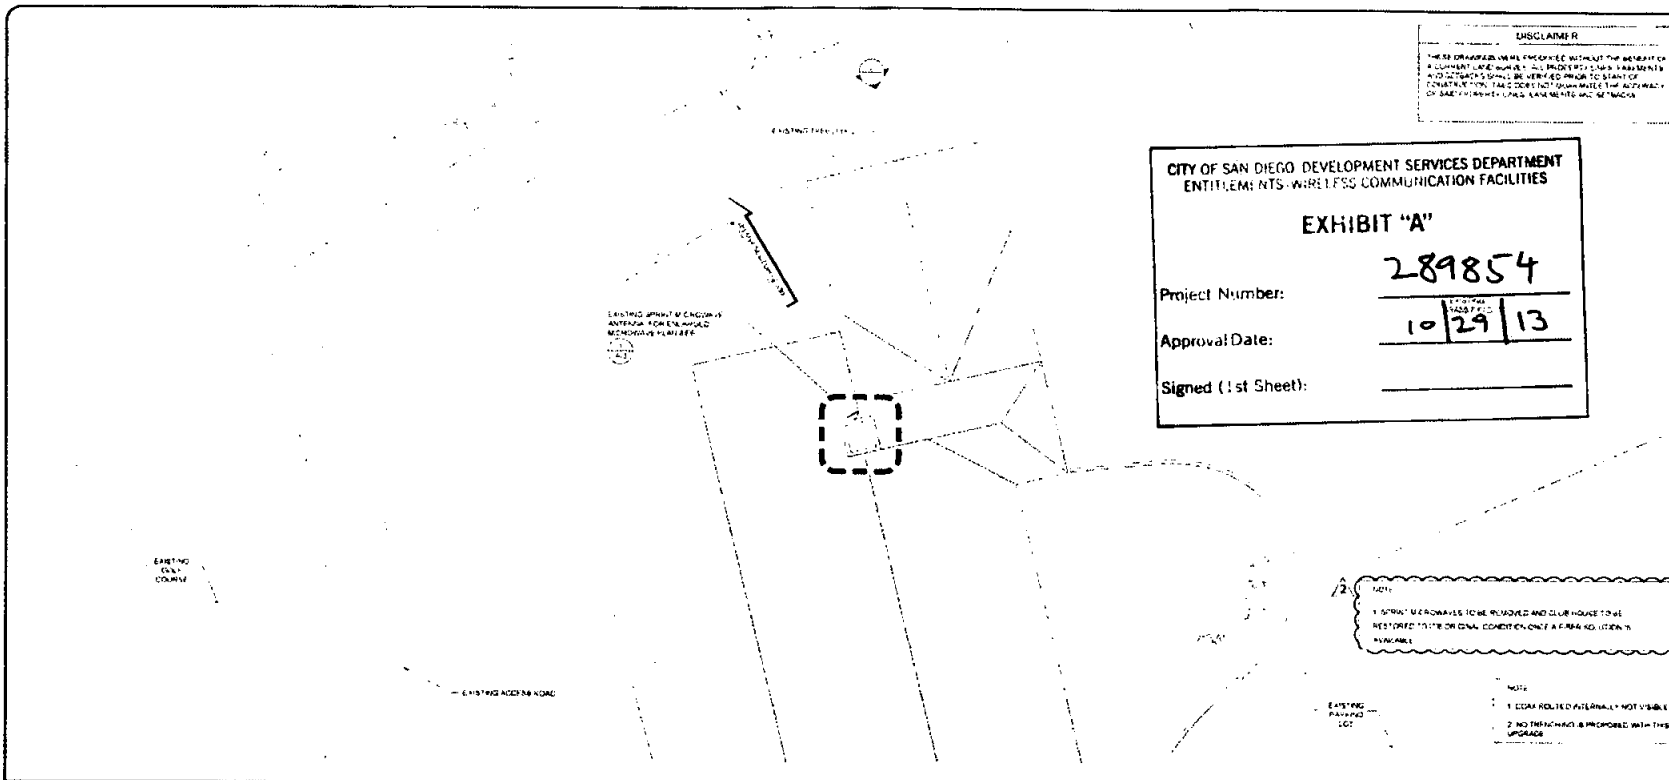

DISCLAIMER


CITY OF SAN DIEGO DEVELOPMENT SERVICES DEPARTMENT
ENTITLEMENTS: WIRELESS COMMUNICATION FACILITIES

EXHIBIT "A"

Project Number: **289854**

Approval Date: **10/29/13**


Signed (1st Sheet): _____

NOTE:


CLUBHOUSE SITE PLAN

1" = 10' (24384)
FOR 1" = 10' (24384)

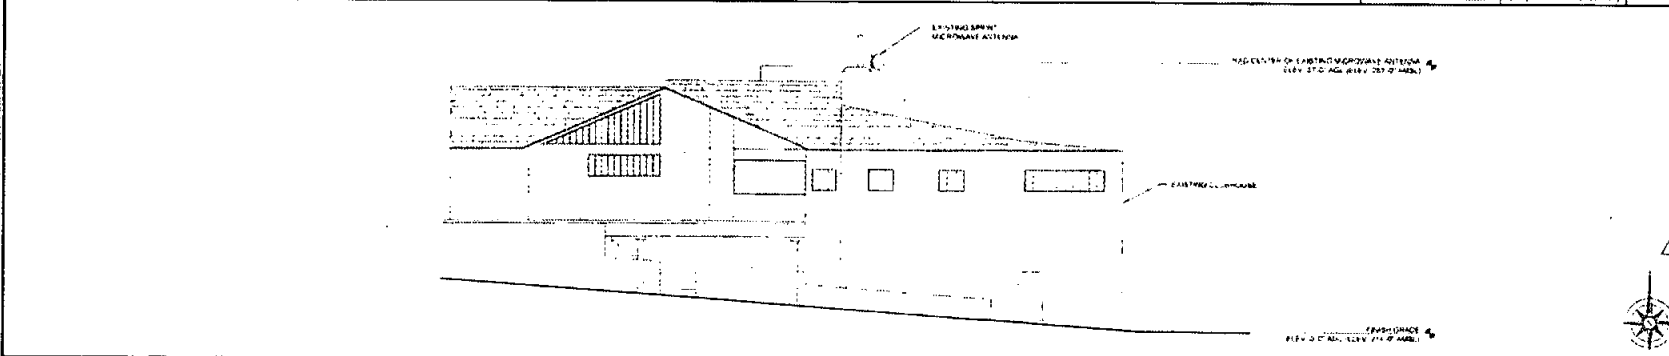

EXISTING CLUBHOUSE NORTH ELEVATION

1" = 10' (24384)
FOR 1" = 10' (24384)



PLANS PREPARED BY:
Technology Associates Engineering Corporation Inc.
SAN DIEGO MARKET OFFICE
5473 KERRY VILLA RD., STE. 300
SAN DIEGO, CA 92123

PROPRIETARY INFORMATION
THE INFORMATION CONTAINED IN THIS DRAWING IS THE PROPERTY OF TECHNOLOGY ASSOCIATES ENGINEERING CORPORATION. IT IS TO BE USED ONLY FOR THE PROJECT AND SITE SPECIFICALLY IDENTIFIED HEREIN. IT IS NOT TO BE REPRODUCED OR TRANSMITTED IN ANY FORM OR BY ANY MEANS, ELECTRONIC OR MECHANICAL, INCLUDING PHOTOCOPYING, RECORDING, OR BY ANY INFORMATION STORAGE AND RETRIEVAL SYSTEM, WITHOUT THE WRITTEN PERMISSION OF TECHNOLOGY ASSOCIATES ENGINEERING CORPORATION.

PROJECT INFORMATION
NETWORK VISION MMBT'S LAUNCH
E. FLORID
SD03XC009
2101 PERSHING DRIVE
SAN DIEGO, CA 92102


ISSUE DATE:
07/22/2013
ISSUED FOR:
100% ZD SUBMITTAL

REVISIONS


REV.	DATE	DESCRIPTION	BY
1	07/22/13	ISSUED FOR 100% ZD REVIEW	AK
2	08/23/13	ISSUED FOR 100% ZD REVIEW	AK
3	08/23/13	ISSUED FOR 100% ZD SUBMITTAL	AK
4	08/23/13	ISSUED FOR 100% ZD SUBMITTAL	AK
5	08/23/13	ISSUED FOR CITY COMMENTS	AK
6	08/23/13	ISSUED FOR CITY COMMENTS	AK
7	08/23/13	ISSUED FOR CITY COMMENTS	AK

LICENSURE:


SHEET TITLE:
CLUBHOUSE SITE PLAN & ELEVATION
SHEET NUMBER:
A-2A
REVISION:
2

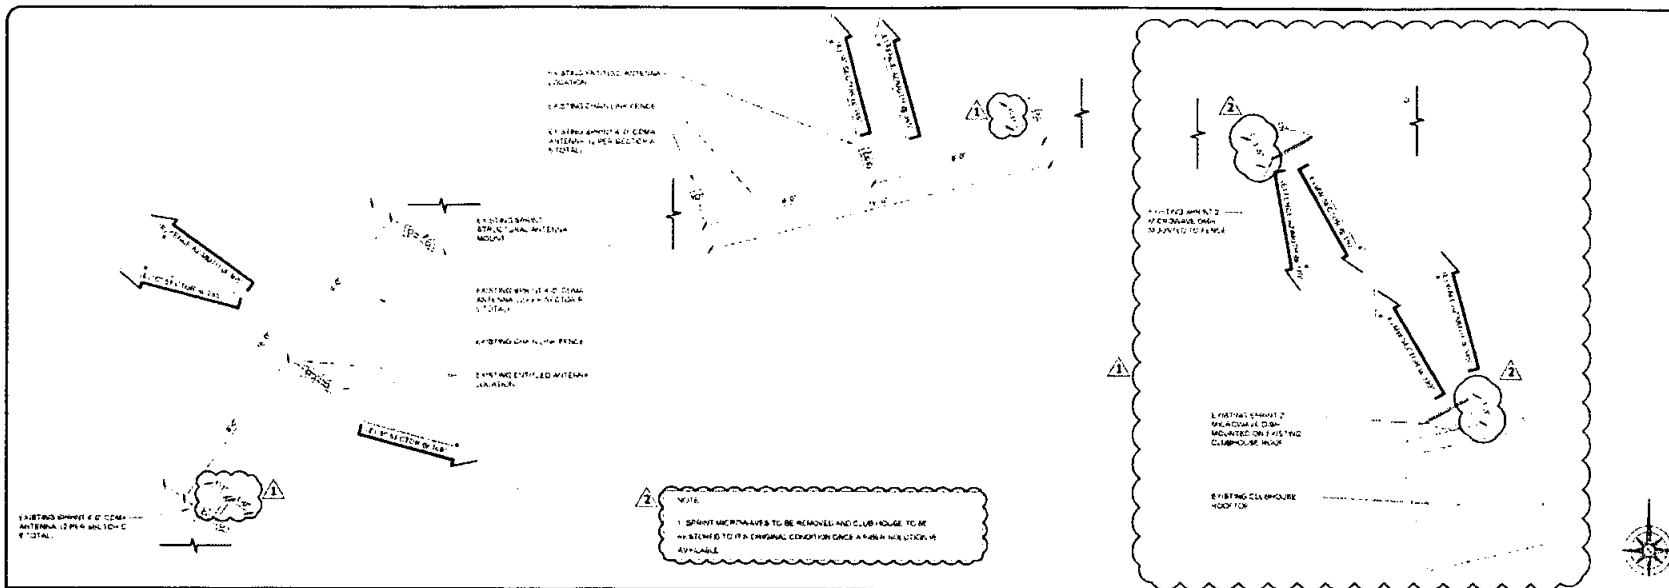

EXISTING ANTENNA PLAN

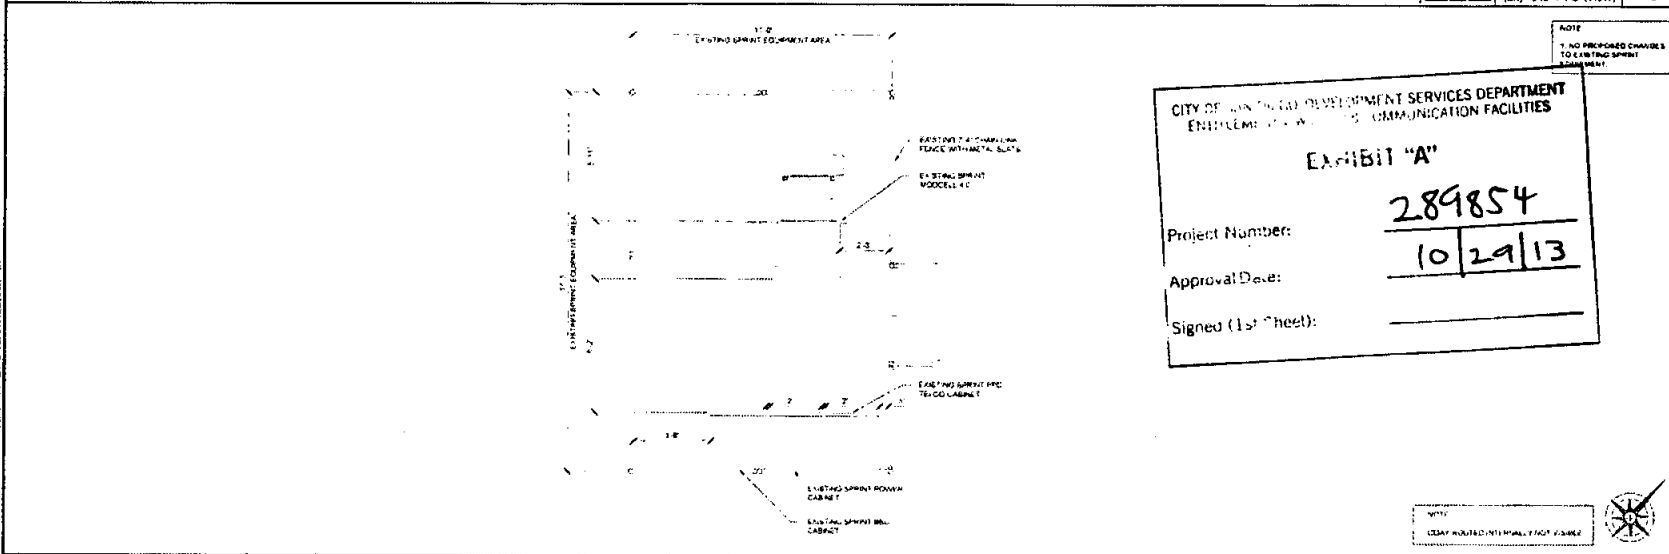

EQUIPMENT PLAN

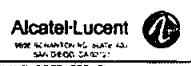

PLANS PREPARED BY:
Technology Associates
Engineering Corporation Inc.
 5473 KEARNY VILLA RD. STE. 300
 SAN DIEGO, CA 92123

PROPRIETARY INFORMATION
 THE INFORMATION CONTAINED HEREIN IS THE PROPERTY OF TECHNOLOGY ASSOCIATES ENGINEERING CORPORATION AND IS NOT TO BE REPRODUCED OR TRANSMITTED IN ANY FORM OR BY ANY MEANS, ELECTRONIC OR MECHANICAL, INCLUDING PHOTOCOPYING, RECORDING, OR BY ANY INFORMATION STORAGE AND RETRIEVAL SYSTEM.

PROJECT INFORMATION
NETWORK VISION NMBTS LAUNCH
E. FLORID
SD03XC009
 2101 PERSHING DRIVE
 SAN DIEGO, CA 92102

ISSUE DATE:
07/22/2013

ISSUED FOR:
100% ZD SUBMITTAL

REVISIONS				
REV	DATE	DESCRIPTION	BY	CHK
1	06/24/12	ISSUED FOR 100% ZD REVIEW	AC	
2	06/24/12	ISSUED FOR 100% ZD REVIEW	SMC	
3	06/24/12	ISSUED FOR 100% ZD REVIEW	AC	
4	07/15/13	ISSUED FOR 100% ZD REVIEW	CM	
5	07/15/13	ISSUED FOR CITY COMMENTS	NAB	
6	07/15/13	ISSUED FOR CITY COMMENTS	NAB	
7	07/15/13	ISSUED FOR CITY COMMENTS	AC	

LICENSURE:

SHEET TITLE:
EXISTING ANTENNA & EQUIPMENT PLANS

SHEET NUMBER: **A-3** REVISION: **2**

CITY OF SAN DIEGO DEVELOPMENT SERVICES DEPARTMENT
 ENVIRONMENTAL & COMMUNICATION FACILITIES

EXHIBIT "A"

Project Number: **289854**

Approval Date: **10/29/13**

Signed (1st Sheet): _____

Sprint

Alcatel-Lucent

PLANS PREPARED BY:

**Technology Associates
Engineering Corporation Inc.**

SAN DIEGO MARKET OFFICE
5473 KEARNY VILLA RD. STE. 300
SAN DIEGO, CA 92123

PROPRIETARY INFORMATION

THE INFORMATION CONTAINED HEREIN IS
THE PROPERTY OF SPRINT AND IS NOT TO BE
REPRODUCED OR TRANSMITTED IN ANY FORM
OR BY ANY MEANS, ELECTRONIC OR MECHANICAL,
INCLUDING PHOTOCOPYING, RECORDING, OR BY
ANY INFORMATION STORAGE AND RETRIEVAL
SYSTEM, WITHOUT PERMISSION IN WRITING
FROM SPRINT.

PROJECT INFORMATION:

NETWORK VISION MMBTS LAUNCH

E. FLORID

SD03XC009

2101 PERSHING DRIVE
SAN DIEGO, CA 92102

ISSUE DATE:

07/22/2013

ISSUED FOR:

100% 2D SUBMITTAL

REVISIONS

REV	DATE	DESCRIPTION	BY
1	06/20/12	ISSUED FOR 100% 2D REVIEW	AC
2	06/20/12	ISSUED FOR 100% 2D REVIEW	SMS
3	06/20/12	ISSUED FOR 100% 2D SUBMITTAL	AC
4	07/22/13	ISSUED FOR 100% 2D SUBMITTAL	CAN
5	07/22/13	ISSUED FOR CITY COMMENTS	NAB
6	07/22/13	ISSUED FOR CITY COMMENTS	NAB
7	07/22/13	ISSUED FOR CITY COMMENTS	AC

LICENSURE:

SHEET TITLE:

**PROPOSED ANTENNA
PLAN**

SHEET NUMBER:

A-4

REVISION:

2

CITY OF SAN DIEGO COMMUNICATIONS DEPARTMENT
COMMUNICATION FACILITIES

EXHIBIT "A"

Project Number: **289854**

Approval Date: **10/29/13**


Signed (City Sheet): _____

PROPOSED ANTENNA PLAN


SCALE: 3/8" = 1'-0" (24/32)
OR: 3/16" = 1'-0" (12/32)

1

0 1 2 

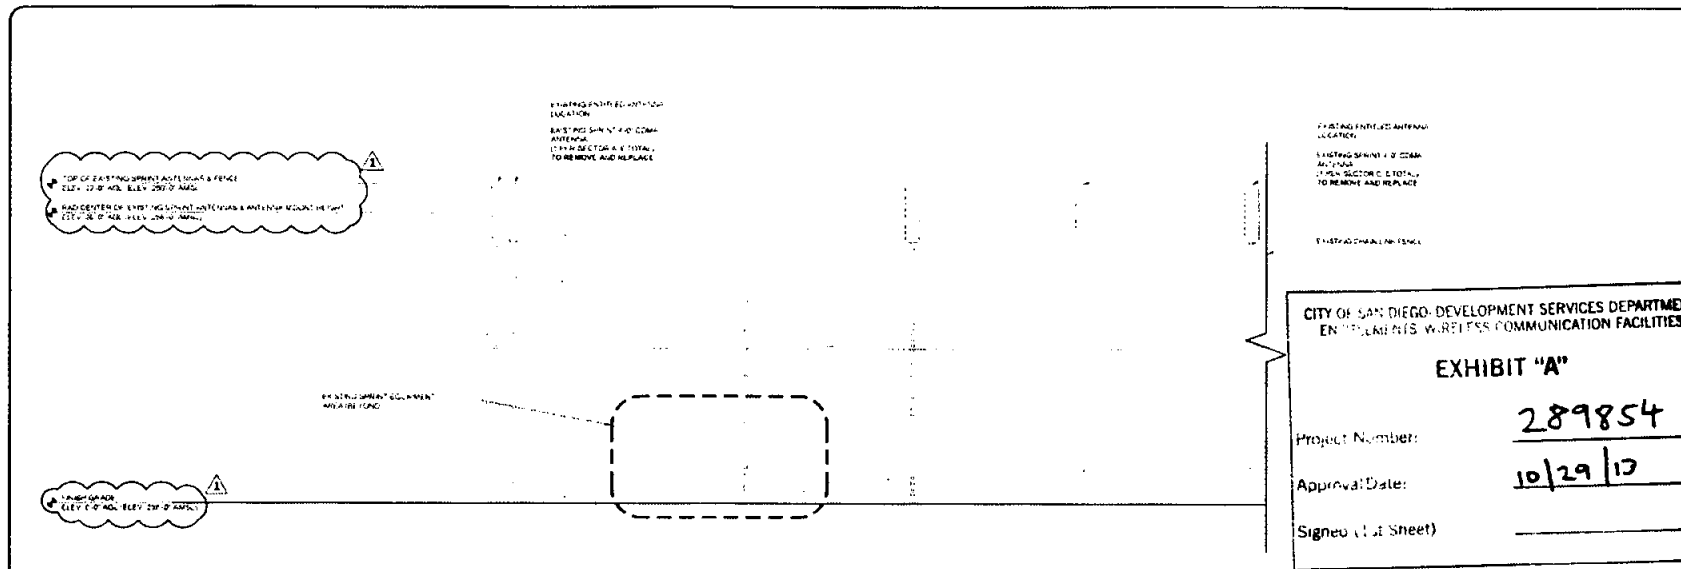

EXISTING NORTHWEST ELEVATION

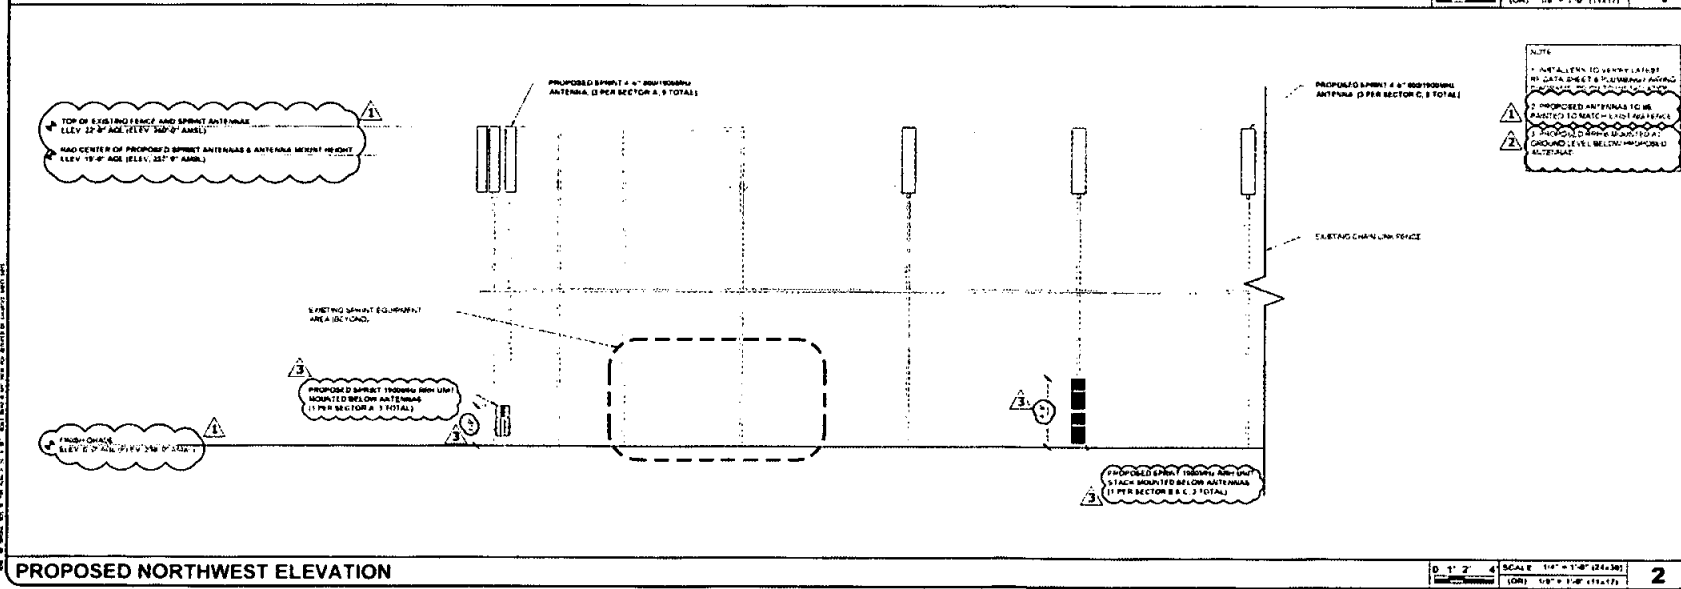

PROPOSED NORTHWEST ELEVATION

Sprint

Alcatel-Lucent

PLANS PREPARED BY:

Technology Associates
Engineering Corporation Inc.
SAN DIEGO MARKET OFFICE
6773 KEARNY WILLY RD. STE. 300
SAN DIEGO, CA 92123

PROPRIETARY INFORMATION
THE INFORMATION CONTAINED HEREIN IS THE PROPERTY OF TECHNOLOGY ASSOCIATES ENGINEERING CORPORATION. IT IS TO BE USED ONLY FOR THE PROJECT AND SITE SPECIFICALLY IDENTIFIED HEREIN. NO PART OF THIS DOCUMENT IS TO BE REPRODUCED OR TRANSMITTED IN ANY FORM OR BY ANY MEANS, ELECTRONIC OR MECHANICAL, INCLUDING PHOTOCOPYING, RECORDING, OR BY ANY INFORMATION STORAGE AND RETRIEVAL SYSTEM.

PROJECT INFORMATION:

NETWORK VISION MMBTS LAUNCH

E. FLORID
SD03XC009

2101 PERSHING DRIVE
SAN DIEGO, CA 92102

ISSUE DATE:

07/22/2013

ISSUED FOR:

100% ZD SUBMITTAL

REVISIONS

REV.	DATE	DESCRIPTION	BY
0	06/03/12	ISSUED FOR SAN ZD REVIEW	AL
1	06/04/12	ISSUED FOR 100% ZD REVIEW	SPD
2	06/11/12	ISSUED FOR 100% ZD SUBMITTAL	AL
3	07/01/12	ISSUED FOR 100% ZD SUBMITTAL	CMD
4	07/01/12	ISSUED FOR CITY COMMENTS	MD
5	07/02/13	ISSUED FOR CITY COMMENTS	AC

LICENSE:

SHEET TITLE:

NORTHWEST
ELEVATIONS

SHEET NUMBER:

REVISION:

A-6 2

Sprint






SD03XC009

E. FLORID

2101 PERSHING DRIVE
SAN DIEGO, CA 92102

Technology  Associates

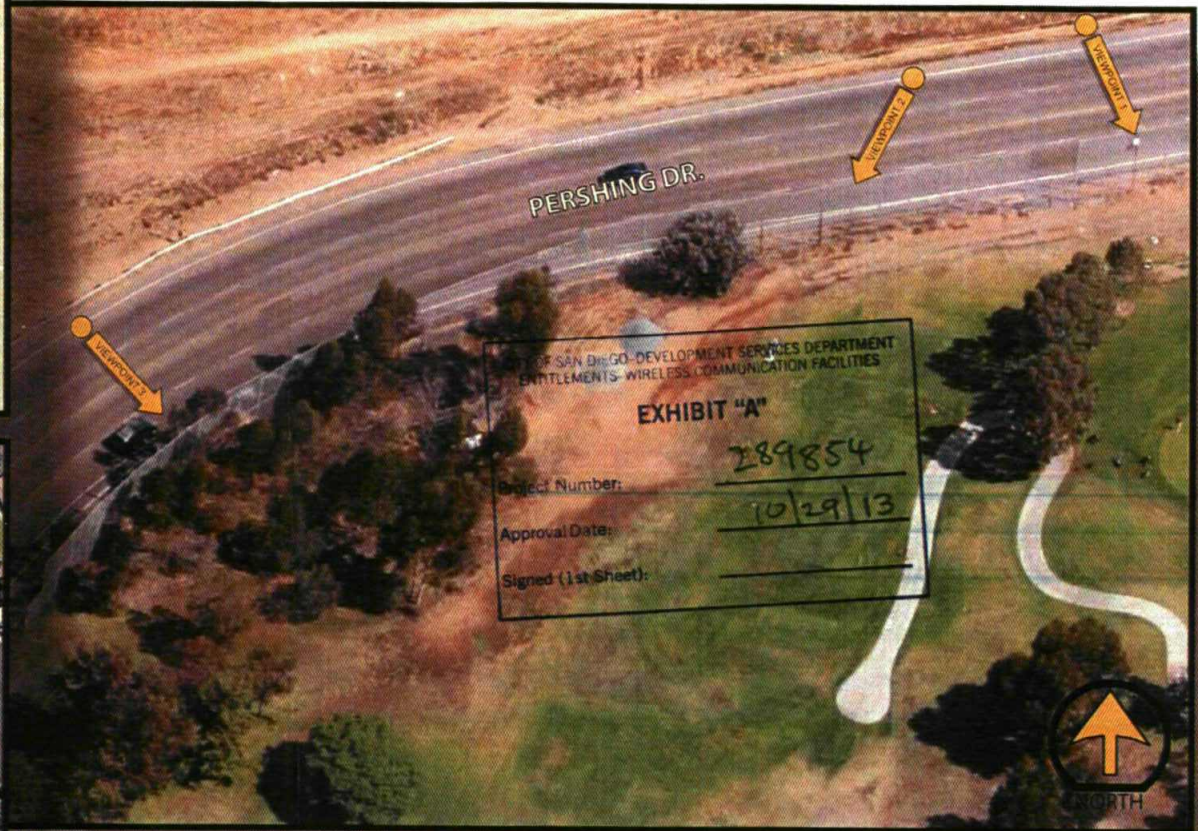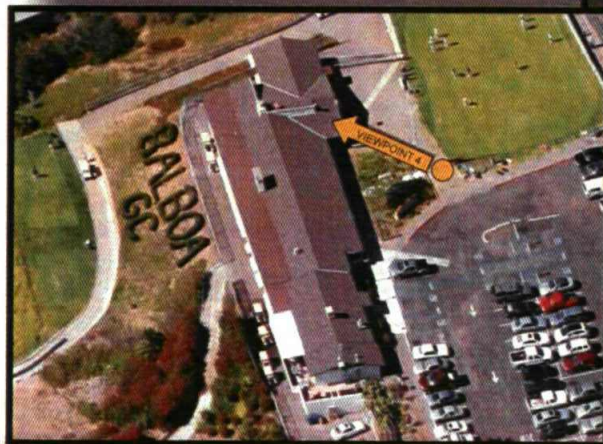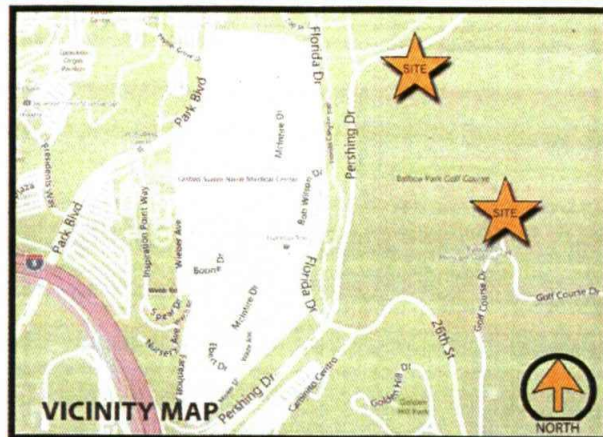

AERIAL MAP




SD03XC009
E. FLORID
2101 PERSHING DRIVE
SAN DIEGO, CA 92102

Technology  Associates



EXISTING

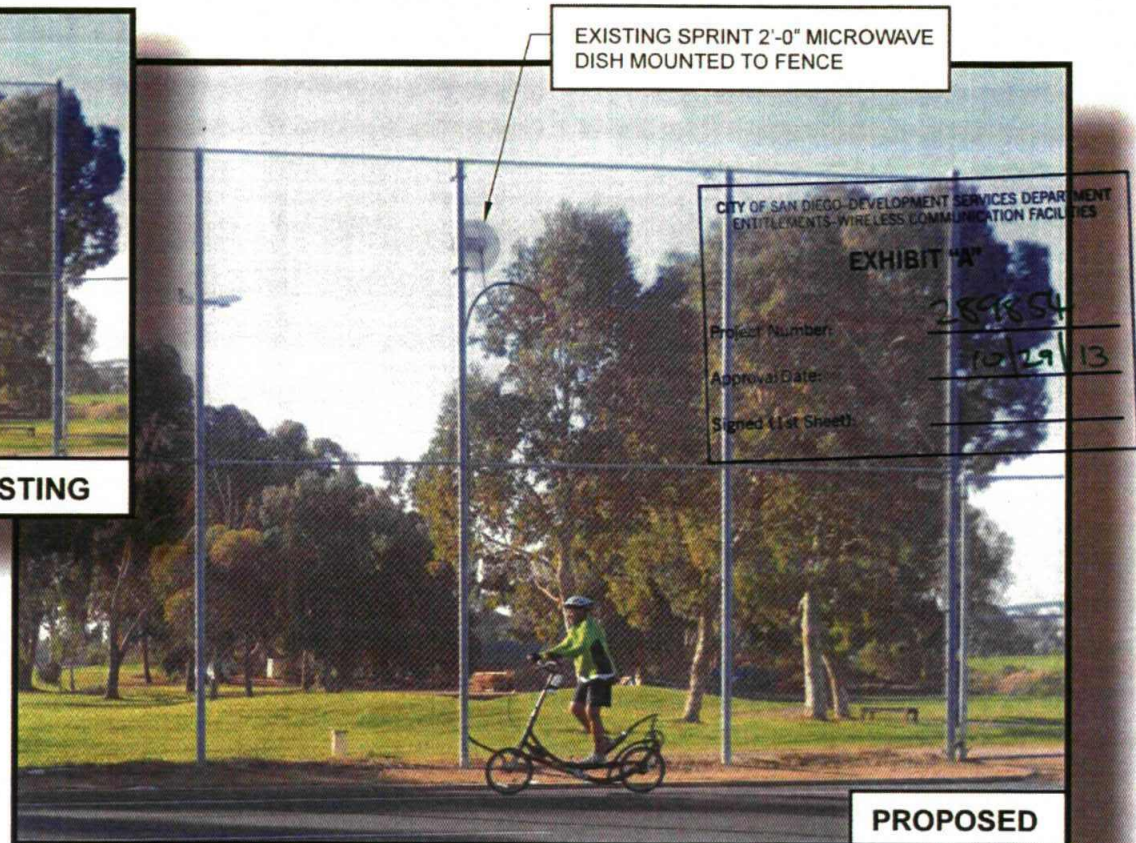

PROPOSED

VIEWPOINT 1

Sprint




SD03XC009

E. FLORID

2101 PERSHING DRIVE
SAN DIEGO, CA 92102

Technology  Associates

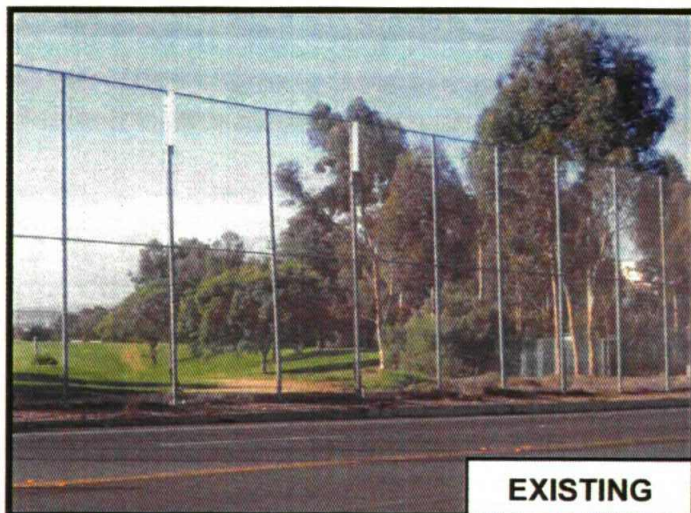

EXISTING



PROPOSED

CITY OF SAN DIEGO-DEVELOPMENT SERVICES DEPARTMENT
ENTITLEMENTS-WIRELESS COMMUNICATION FACILITIES

EXHIBIT "A"

Project Number: 289854

Approval Date: 10/29/13

Signed (1st Sheet): _____

VIEWPOINT 2



SD03XC009
E. FLORID
2101 PERSHING DRIVE
SAN DIEGO, CA 92102

Technology  Associates



EXISTING


CITY OF SAN DIEGO-DEVELOPMENT SERVICES DEPARTMENT
ENTITLEMENTS-WIRELESS COMMUNICATION FACILITIES

EXHIBIT "A"

Project Number: 289854

Approval Date: 10/29/13

Signed (1st Sheet): _____

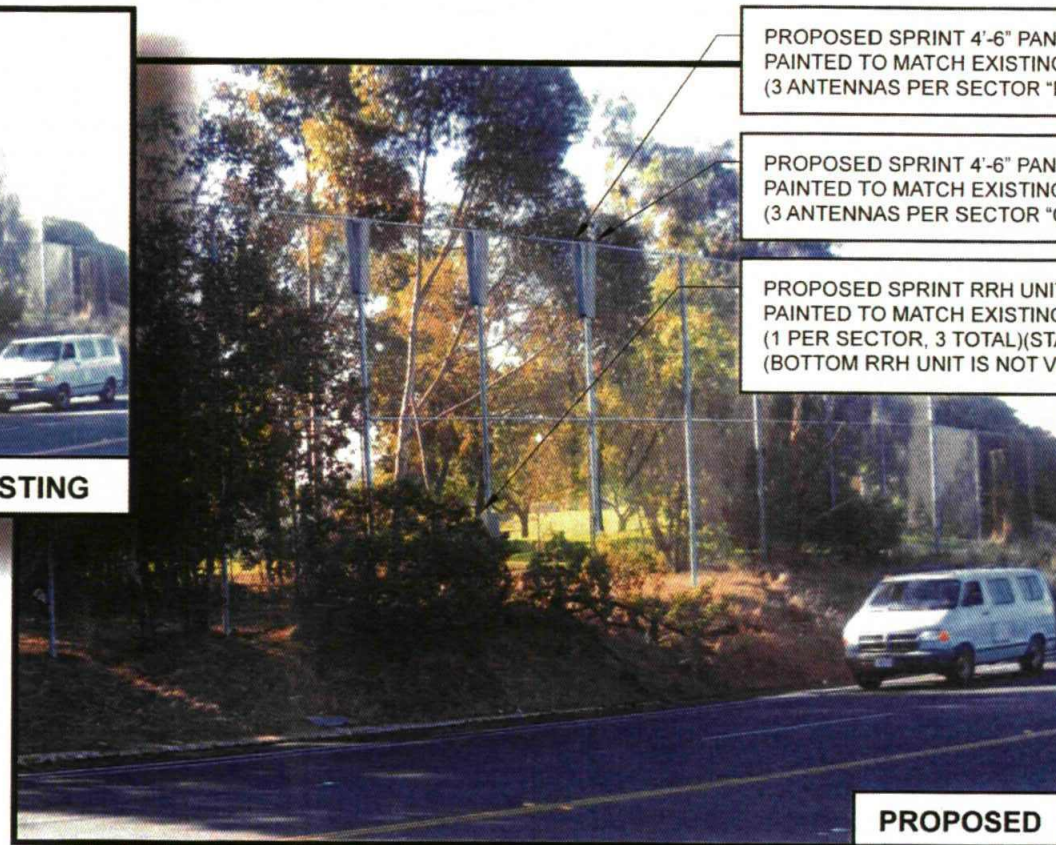

PROPOSED

PROPOSED SPRINT 4'-6" PANEL ANTENNA
PAINTED TO MATCH EXISTING FENCE
(3 ANTENNAS PER SECTOR "B", 9 TOTAL)

PROPOSED SPRINT 4'-6" PANEL ANTENNA
PAINTED TO MATCH EXISTING FENCE
(3 ANTENNAS PER SECTOR "C", 9 TOTAL)


PROPOSED SPRINT RRH UNIT
PAINTED TO MATCH EXISTING FENCE
(1 PER SECTOR, 3 TOTAL)(STACKED)
(BOTTOM RRH UNIT IS NOT VISIBLE)

VIEWPOINT 3



SD03XC009
E. FLORID
2101 PERSHING DRIVE
SAN DIEGO, CA 92102

Technology  Associates

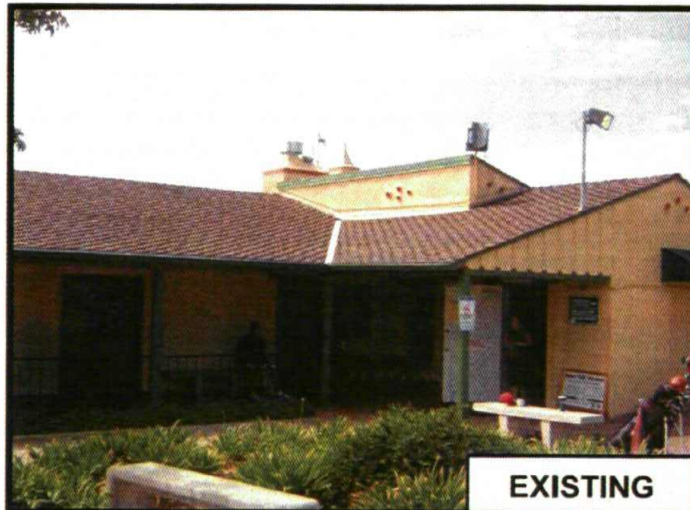

EXISTING


CITY OF SAN DIEGO-DEVELOPMENT SERVICES DEPARTMENT
ENTITLEMENTS-WIRELESS COMMUNICATION FACILITIES

EXHIBIT "A"

Project Number: 289854

Approval Date: 10/29/13

Signed (1st Sheet): _____

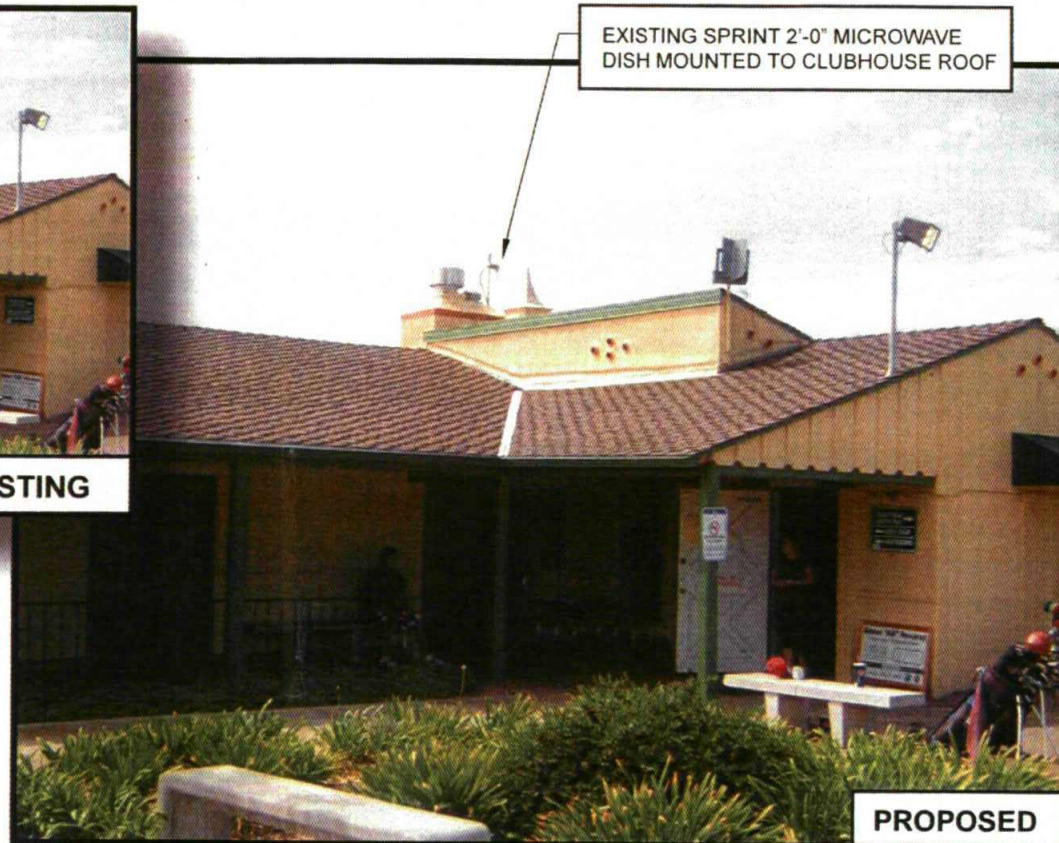

EXISTING SPRINT 2'-0" MICROWAVE
DISH MOUNTED TO CLUBHOUSE ROOF

PROPOSED

VIEWPOINT 4